


Attachment A: MARK-UP indicating earthworks

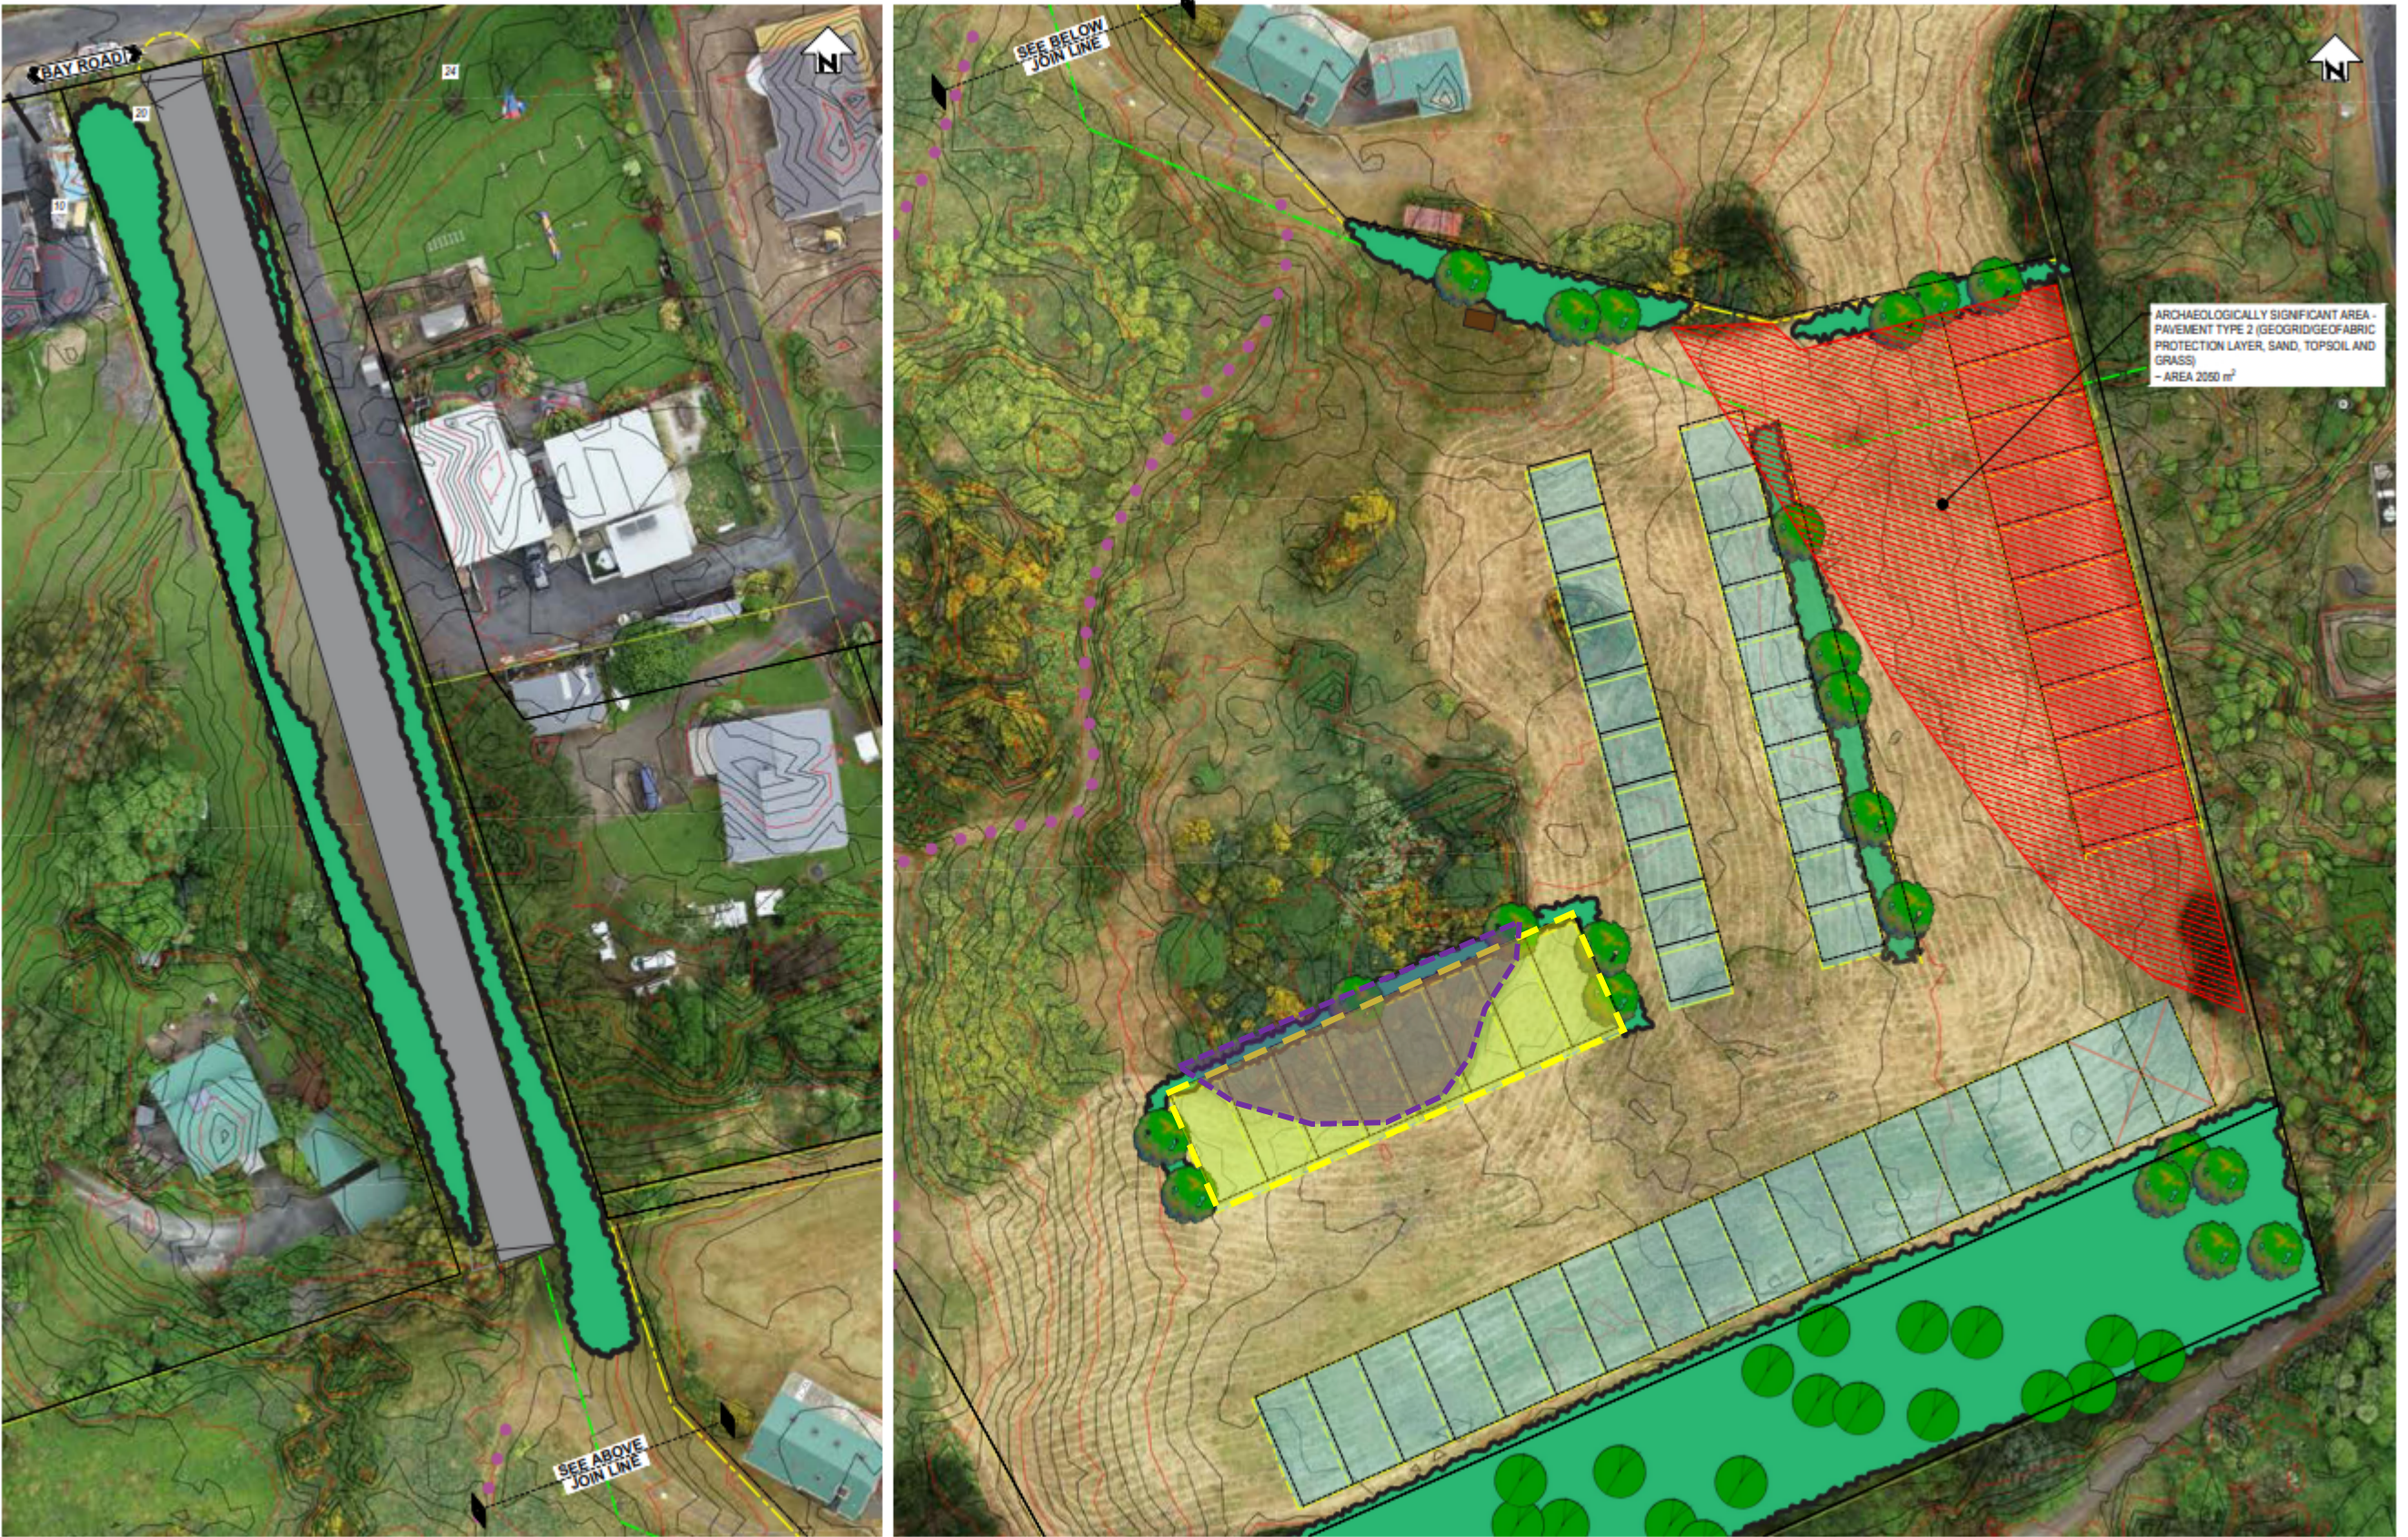

										NOT FOR CONSTRUCTION	
										Sketch Stamp	
										SKETCH	
										Date Stamp	
										15.09.20	
										Scale	
										AS SHOWN	
										Drawing No.	
										310003165-01-001-SK004-1	
										Rev	
										A	

										SURVEYED	
										DESIGNED	
										DRAWN	
										CAD REVIEW	
										APPROVED	
										PROF REGISTRATION	
										TIL	
										2020	
										RIS	
										2020	
										APP	
										15.09.20	
										DATE	

										Stantec	
										20 BAY ROAD, WARRINGTON	
										ACCESS & SITE	
										STAGE 2 PAVEMENT / REINFORCED GRASS	
										SHEET 1 OF 1	